



F:\NLA homework Current Drawing Updating - Work Area Master Plans - Redraw & Corrections\Architectural\NLA-AP-GND-MBP-rev10a-v6.dwg, 30/08/2018 10:23:31 PM, AutoCAD PLOT (General Documentation).pc3

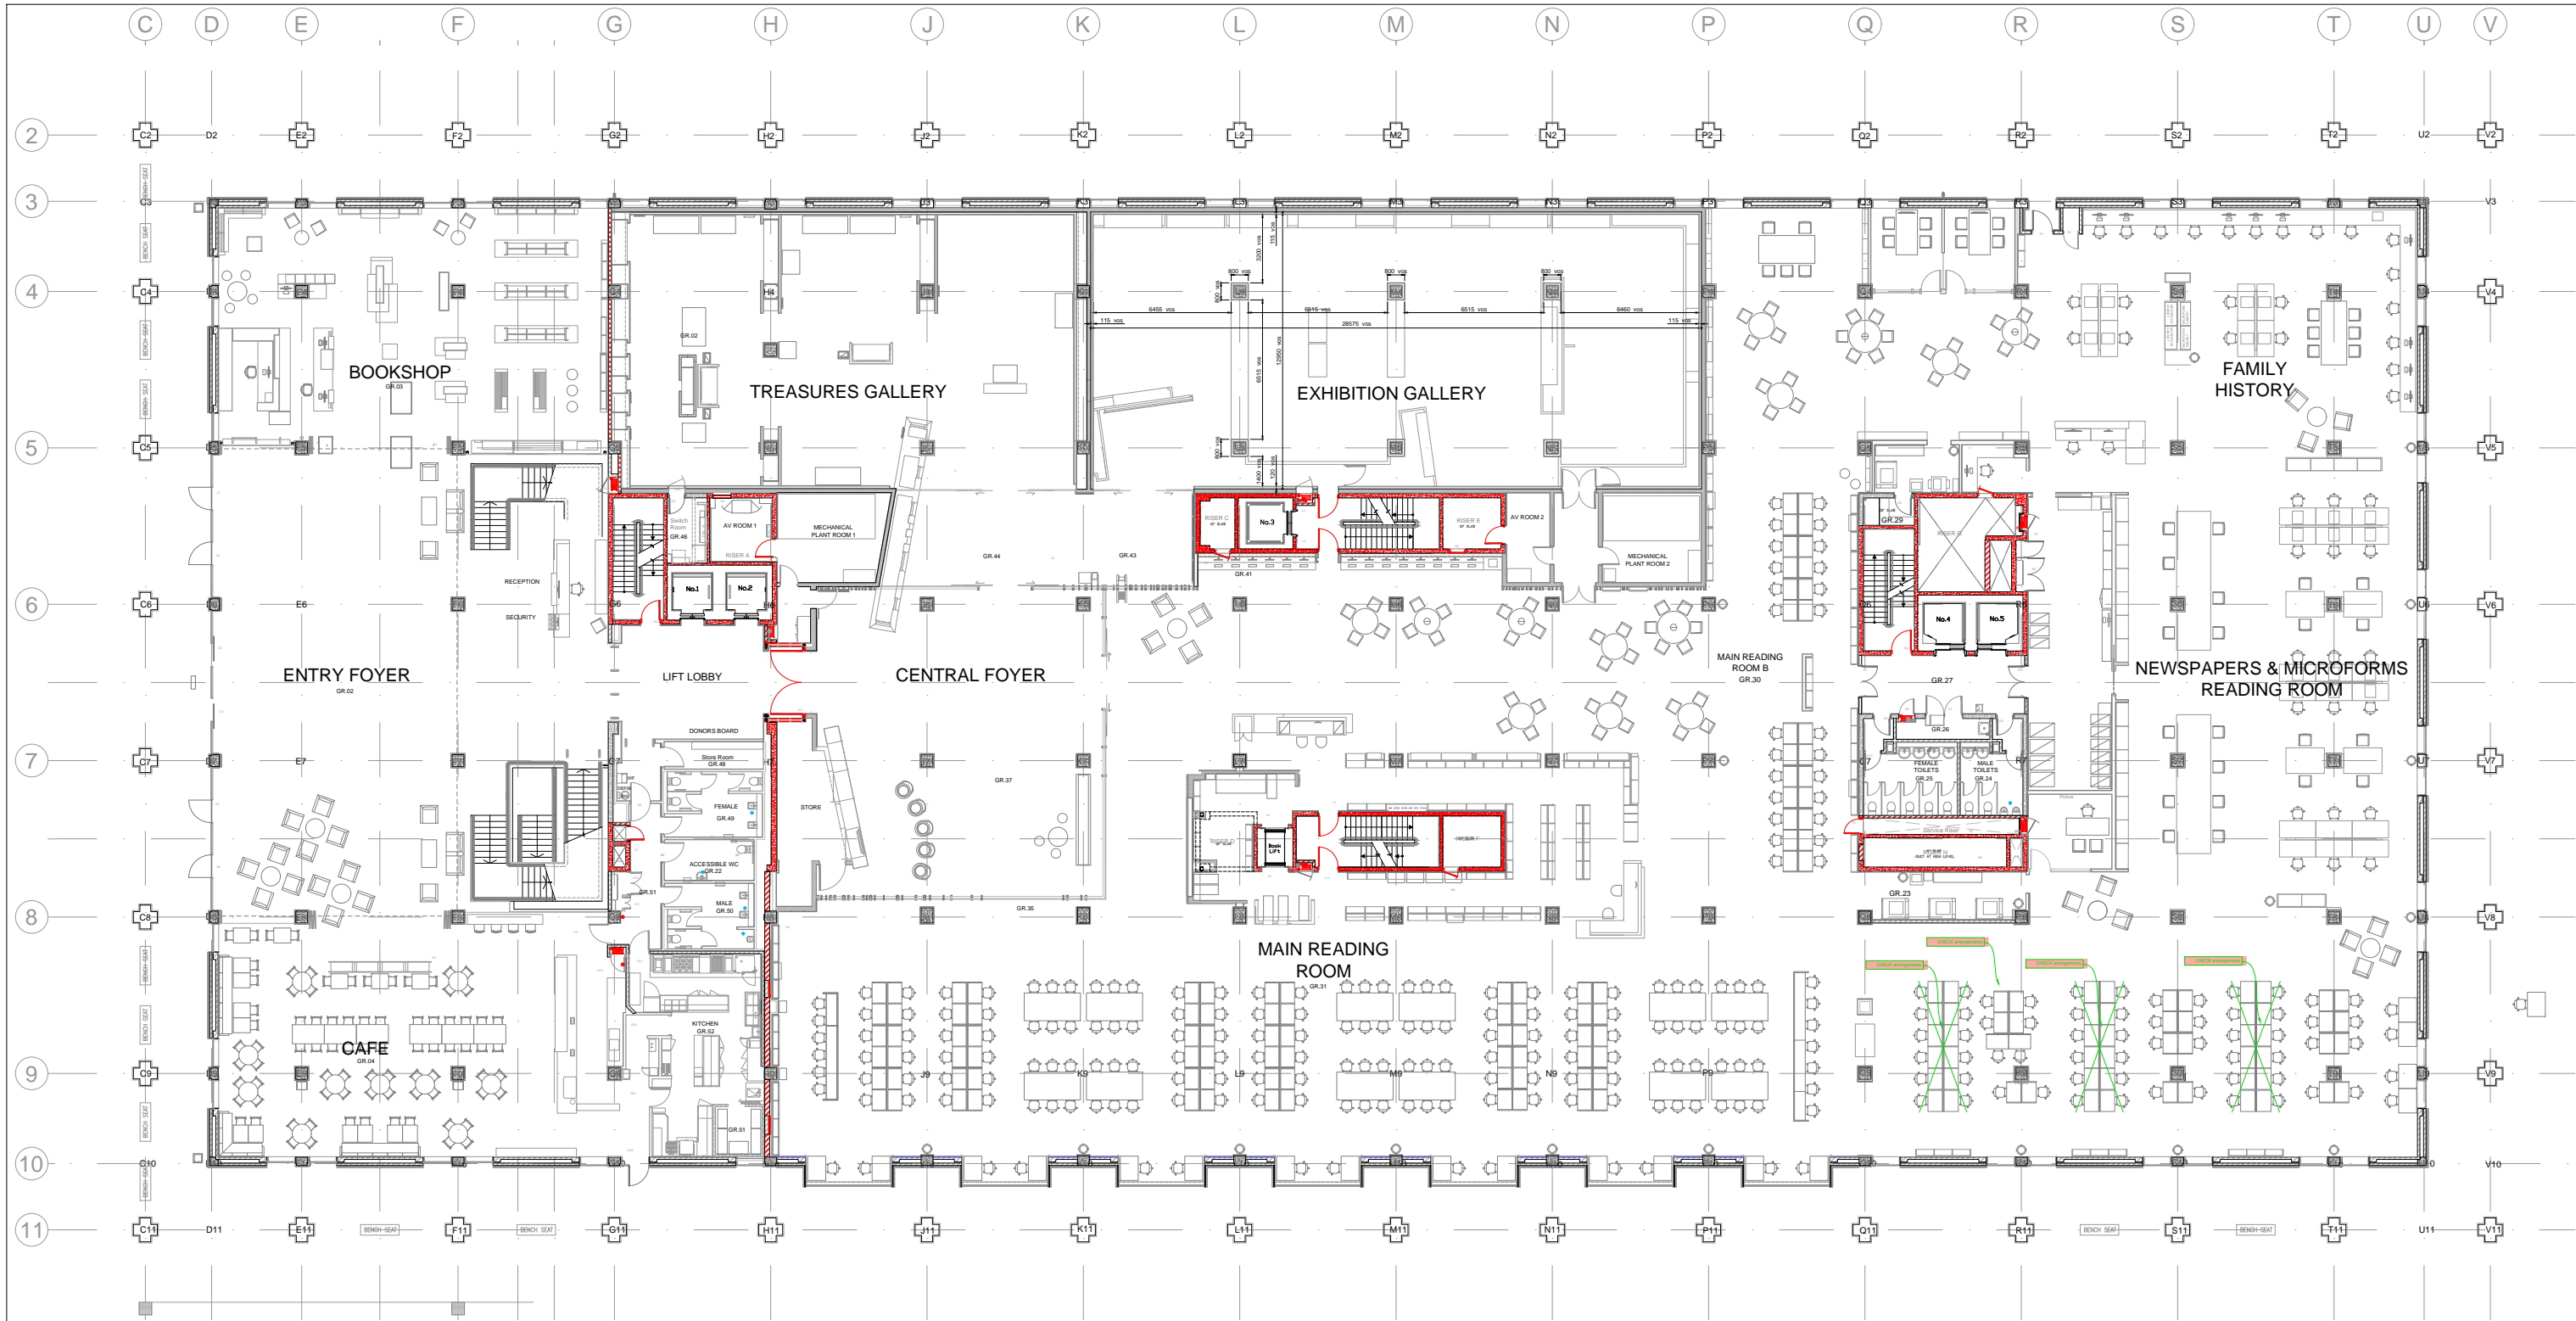

# GROUND FLOOR

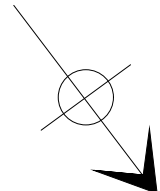

DRAWING REVISIONS			DRAWN BY	SCALE		CLIENT	DRAWING TITLE
NO.	DATE	REVISION					
1	07/03/2007	Issued for Information	MTP	0 2000 4000 6000 8000 10000mm 1:300 @ A3 1:150 @ A1		National Library Of Australia	LEVEL GND FLOOR PLAN + FURNITURE
2	27/04/2011	Treasures Exhibition updated from design drawings					
3	30/09/2011	Book Shop updated	AUTHORISED FOR ISSUE BY	DATE	BASE PLAN REFERENCE NUMBER	PROJECT	G:/DIV6/Building and Security/Services/Builman/Drawings/Master Base Plans/Drawings/NLAParkes/Architectural/NLA-AP-GND-MBP-rev10a-v6.dwg Sheet "Floor Plan + Furniture"
4	27/01/2012	Reading Room Furniture updated					
5	06/02/2013	Podium Planters and Furniture updated	STATUS	1 November 2017	Version	Master Base Plans - Architectural	DRAWING NUMBER NLA-AP-GND-MBP
6	10/06/2015	Ground Floor Refurbishment updated					
7	15/07/2015	External Walls, Windows & Cladding corrected; Detail added	GENERAL INFORMATION			BLOCK 4	DIVISION PARKES
8	10/11/2015	External SW Stairs site measured and corrected					
9a	26/05/2016	Service Cores and Columns corrected against structural drawings				SECTION 27	Rev 10
9b	27/05/2016	Design dimensions per PDFs (1963, 1981, etc) added					
9c	31/05/2016	Podium perimeter capping corrected & glass balustrade updated					TRIM:NLA14/242
9d	12/07/2016	Exhibition Gallery layout updated and issued					
9e	22/07/2016	Book Plate Cafe Refurbishment updated from as-built drawings					
9f	10/08/2016	Toilet Areas (North core 1998) updated					
9g	05/09/2016	Layers rationalised to conform with drafting standard. RE-ISSUED					
9h	09/09/2016	Treasures walls corrected (150mm N-S); Gallery panels shown					
9i	12/09/2016	Disabled access ramp and steps measured and corrected					
10	14/09/2016	Front steps measured and corrected; Main Stairs (South) corrected					
10av2	16/09/2016	Carpet Treasures, Foyer, Reading Room; Book Shop; Newspapers					
v3	27/10/2017	Vinyl AV room; Lift Lobby; Newspapers; Reader Services; Exhibitions					
v4	14/02/2018	Re-issued					
v5	18/02/2018	Floor coverings Legend added; Paving corrected					
v6	31/07/2018	Heritage Furniture updated; Legend added; Ditto Furniture Assets					
		No changes; copied to database manager					
		Room names & numbers corrected					
		No significant changes; copied to database manager					
		Created					

F:\NLA homework Current Drawing Updating - Work Area Master Plans - Redraw & Corrections\Architectural\NLA-AP-GND-MBP-rev10a-v6.dwg, 30/08/2018 10:23:31 PM, AutoCAD PLOT (General Documentation).pc3



# GROUND FLOOR

DRAWING REVISIONS		
NO.	DATE	REVISION
1	07/03/2007	Issued for Information
2	27/04/2011	Treasures Exhibition updated from design drawings
3	30/09/2011	Book Shop updated
4	27/01/2012	Reading Room Furniture updated
5	06/02/2013	Podium Planters and Furniture updated
6	10/06/2015	Ground Floor Refurbishment updated
7	15/07/2015	External Walls, Windows & Cladding corrected; Detail added
8	10/11/2015	External SW Stairs site measured and corrected
9a	26/05/2016	Service Cores and Columns corrected against structural drawings
9b	27/05/2016	Stairs and service cores site measured and corrected
9c	31/05/2016	Design dimensions per PDFs (1963, 1981, etc) added
		Internal walls corrected from site measurements; Doors corrected
		Podium perimeter capping corrected & glass balustrade updated

9d	12/07/2016	Exhibition Gallery layout updated and issued
9e	22/07/2016	Book Plate Cafe Refurbishment updated from as-built drawings
		Toilet Areas (North core 1998) updated
9f	10/08/2016	Layers rationalised to conform with drafting standard. RE-ISSUED
9g	05/09/2016	Treasures walls corrected (150mm N-S); Gallery panels shown
9h	09/09/2016	Disabled access ramp and steps measured and corrected
		Front steps measured and corrected; Main Stairs (South) corrected
9i	12/09/2016	Carpet Treasures, Foyer, Reading Room; Book Shop; Newspapers
		Vinyl AV room; Lift Lobby; Newspapers; Reader Services; Exhibitions
10	14/09/2016	Re-issued
10av2	16/09/2016	Floor coverings Legend added; Paving corrected
v3	27/10/2017	Heritage Furniture updated; Legend added; Ditto Furniture Assets
v4	14/02/2018	No changes; copied to database manager
v5	18/02/2018	Room names & numbers corrected
	25/07/2018	No significant changes; copied to database manager
v6	31/07/2018	Created

DRAWN BY	
MTP	
AUTHORISED FOR ISSUE BY	
DATE / /	
STATUS	
GENERAL INFORMATION	

SCALE	
0 2000 4000 6000 8000 10000mm	
1:300 @ A3 1:150 @ A1	
BASE PLAN REFERENCE NUMBER	
Version	
NLA-AP-GND-MBP	
ISSUE DATE	
1 November 2017	




CLIENT		
National Library Of Australia		
PROJECT		
Master Base Plans		
- Architectural		
BLOCK	SECTION	DIVISION
4	27	PARKES


DRAWING TITLE	
LEVEL GND	
FLOOR PLAN + FURNITURE	
G:/DIV6/Building and Security/Services/Builman/	
Drawings/Master Base Plans/Drawings/NLAParkes/Architectural/	
NLA-AP-GND-MBP-rev10a-v6.dwg	
Sheet "Floor Plan + Furniture"	
TRIM:NLA14/242	
DRAWING NUMBER	
NLA-AP-GND-MBP	
Rev	
10	




F:\NLA homework\Current Drawing Updating - Work Area Master Plans - Redraw & Corrections\Architectural\NLA-AP-L1-MBP-rev8-v4.dwg, 30/08/2018 9:11:31 PM, AUTOCAD PDF (General Documentation).pc3

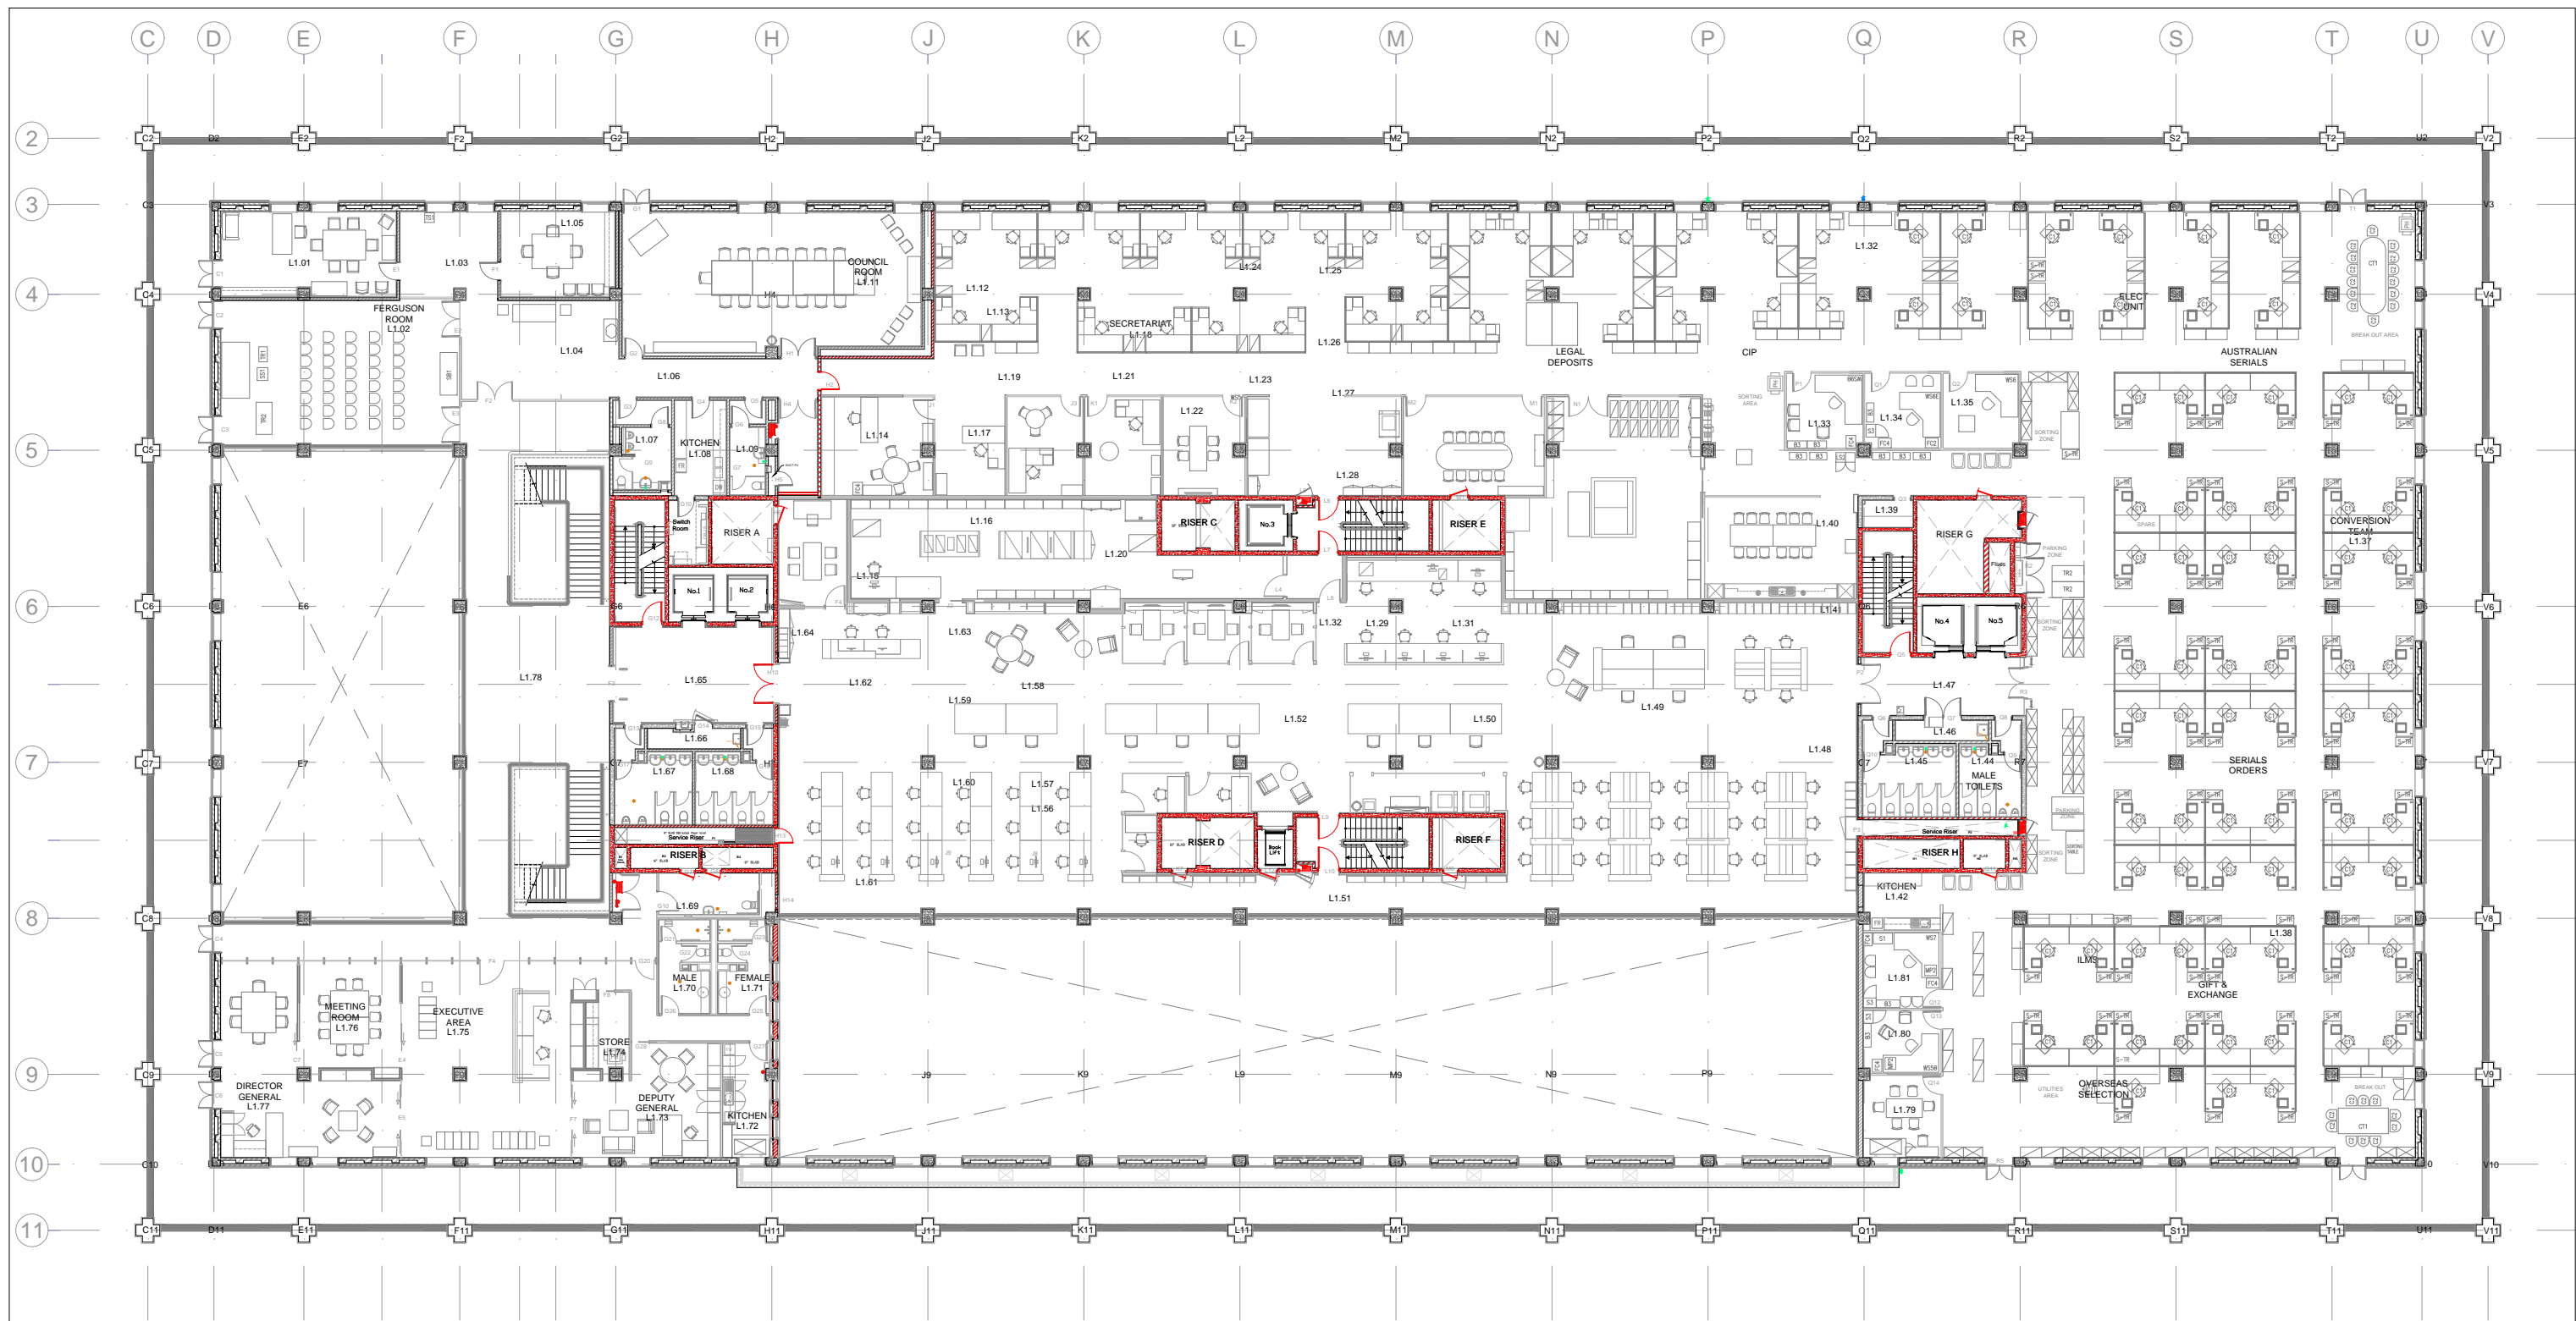


# LEVEL 1


DRAWING REVISIONS			<div>18/09/2016 AutoCAD layer &amp; colours rationalised and layers adjusted to conform with drafting standard. Revisions page amended Balcony details (1963) checked;Thresholds; Quarry Tiles added</div> <div>06/10/2016 Executive areas corrected &amp; updated; Toilet areas corrected Reading Room walls corrected, details added, balustrade corrected Fire walls checked; Viewing windows added; Floor coverings added</div> <div>8 26/10/2016 RE-ISSUED for Information</div> <div>v2 29/09/2017 Heritage Furniture Separated; Room Name Layers changed</div> <div>14/02/2018 copied to database manager</div> <div>v3 25/07/2018 No significant changes; copied to database manager</div> <div>v4 31/07/2018 Created</div>	DRAWN BY		<div>SCALE</div> <div><div>0200040006000800010000mm</div></div> <div>1:300 @ A3 1:150 @ A1</div>	<div></div>	CLIENT			DRAWING TITLE		
NO.	DATE	REVISION		National Library Of Australia				LEVEL 1 FLOOR PLAN W FURNITURE					
1	07/03/2007	Issued for Information		<div>AUTHORISED FOR ISSUE BY</div> <div>DATE</div> <div>/ /</div> <div>STATUS</div> <div>Redraw - For Information</div>				PROJECT			G:/DIV6/Building and SecurityServices/Builman/ Drawings/Master Base Plans/Drawings/NLAParkes/Architectural/ NLA-AP-L1-MBP-rev8-v4.dwg Sheet "Floor Plan w Furniture"		
2	18/09/2009	Compactus updated						BASE PLAN REFERENCE NUMBER			Version		
3	06/01/2011	Staff Amenities and ILMS updated						NLA-AP-L1-MBP					
4	30/05/2012	Furniture and workstations updated	ISSUE DATE				26 October 2016						
5	27/05/2015	Reading Room Level 1 Fitout; Furniture updated				BLOCK			SECTION	DIVISION	DRAWING NUMBER	Rev	
6	03/03/2016	External Walls and windows corrected. Detail added				4			27	PARKES			NLA-AP-L1-MBP
6a	27/03/2016	Columns & walls corrected against structural drawings (1963) Service cores and Stairs corrected - and site measured Main Stairs corrected and Redrawn										TRIM:NLA14/242	
7a	13/04/2016	Internal walls corrected (where remaining); construction shown Doors corrected; Fire walls shown											
	28/04/2016	2015 site measurements recorded; All elements adjusted Internal walls corrected (where remaining); construction shown											

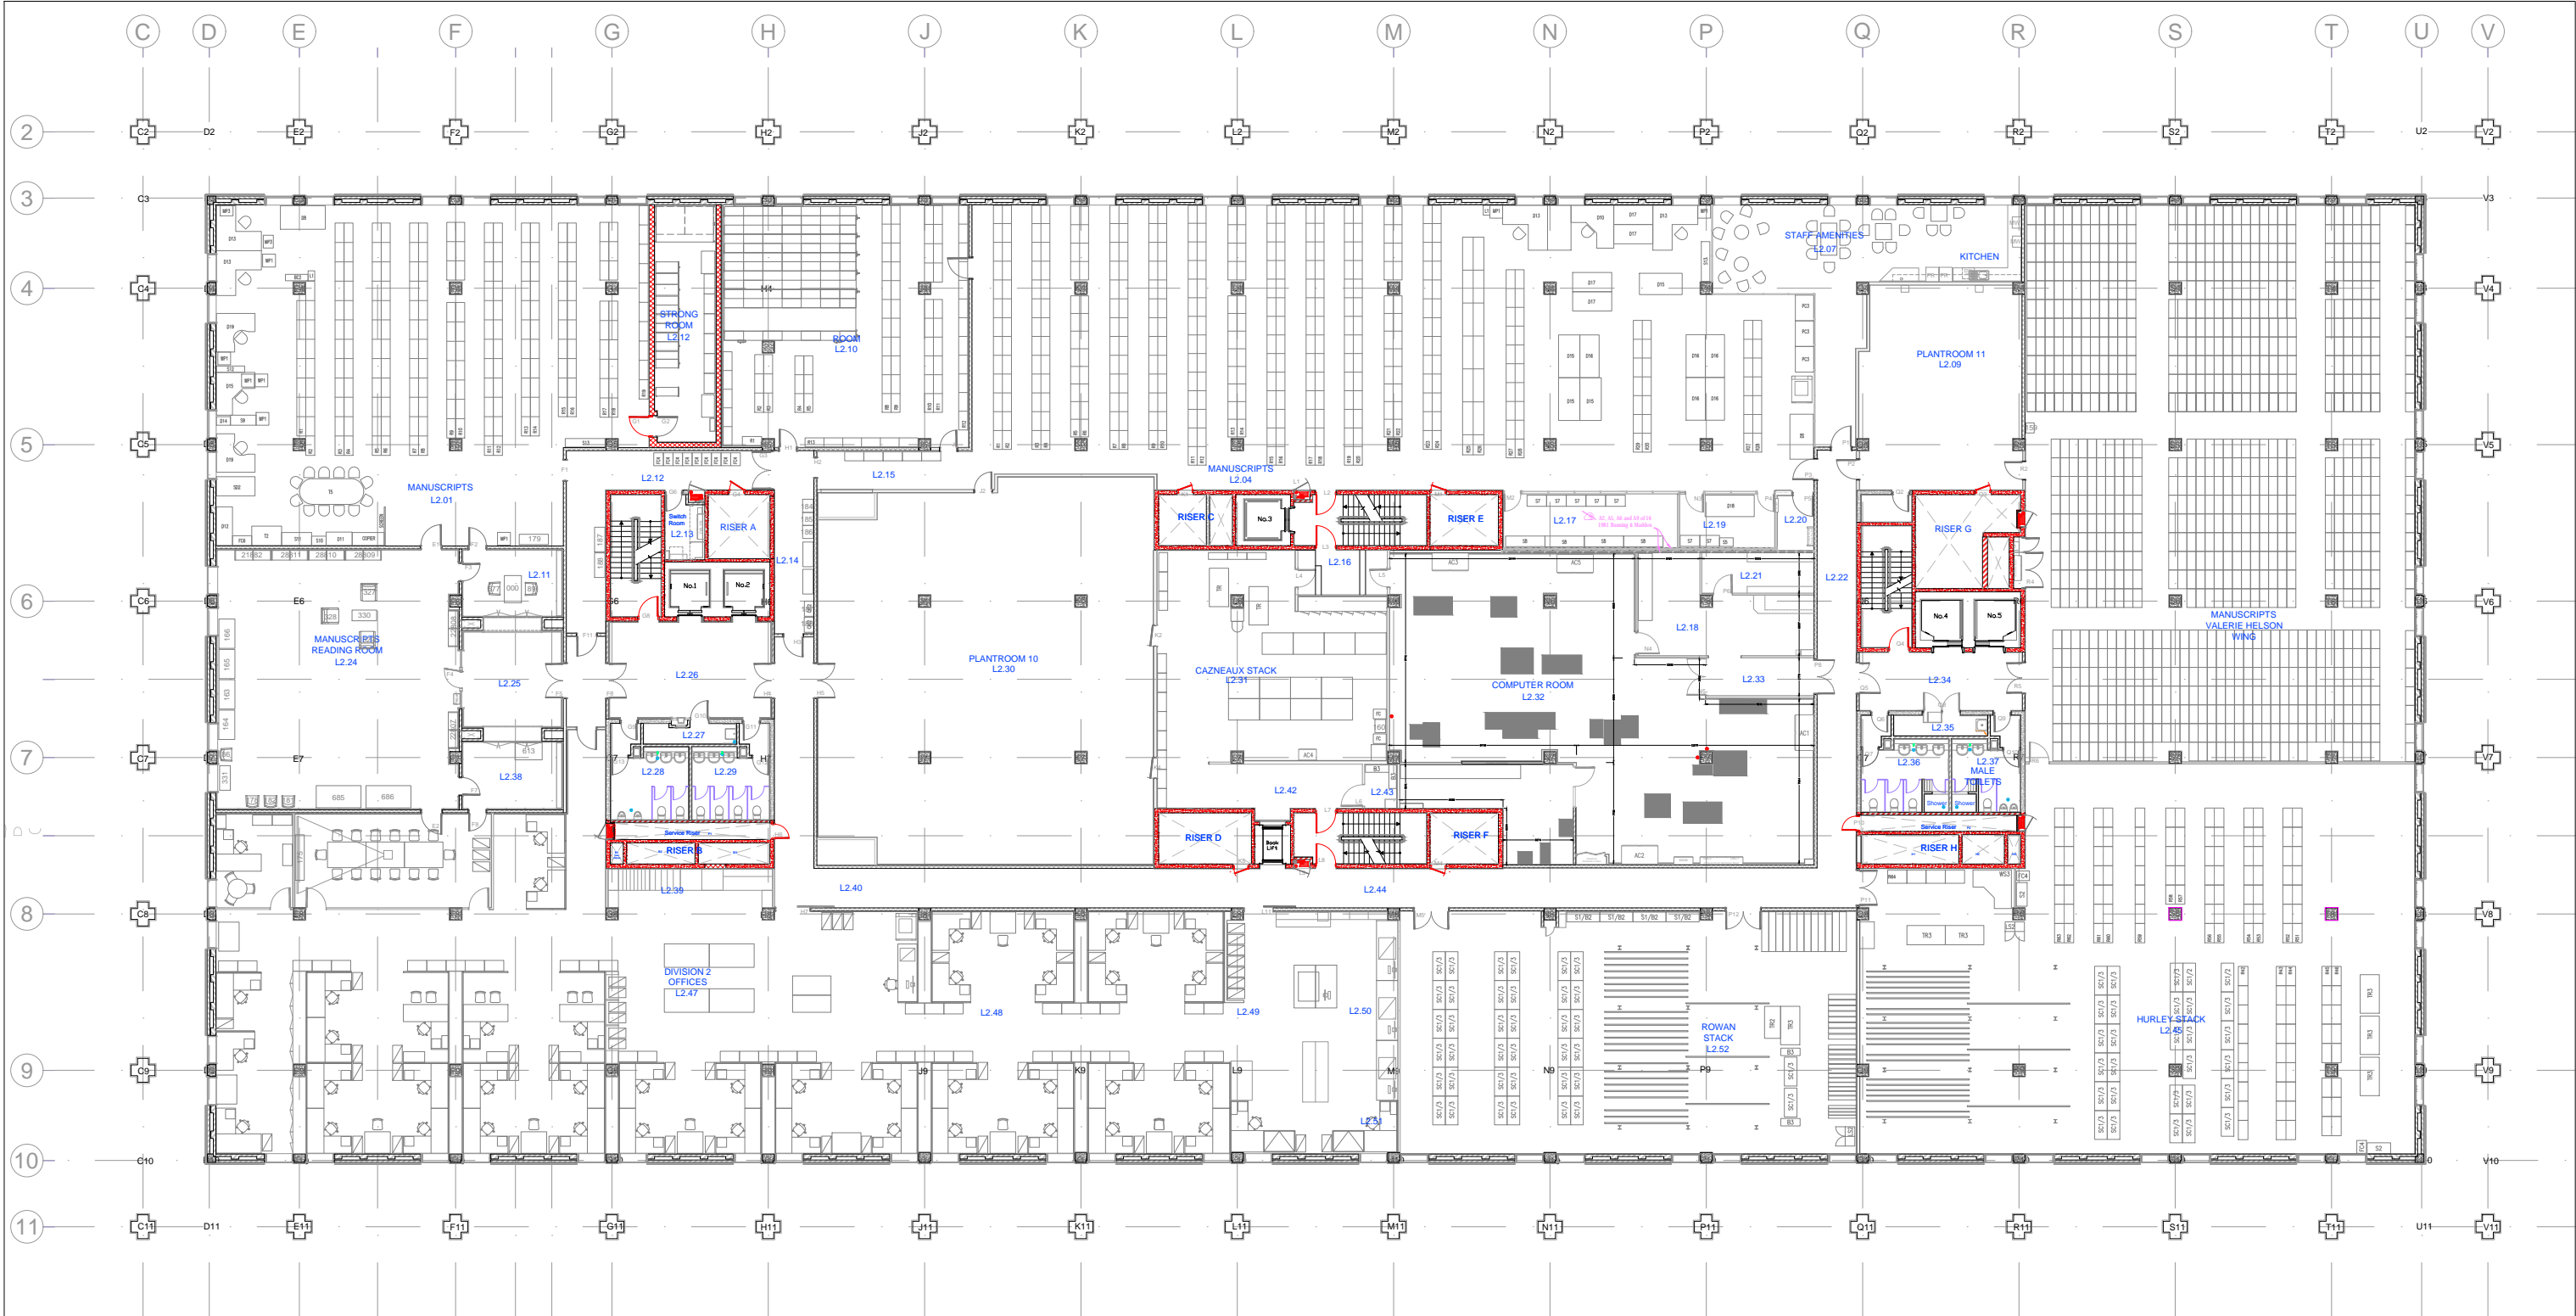

LEVEL 2


<div>DRAWING REVISIONS</div> <table><tr><th>NO.</th><th>DATE</th><th>REVISION</th></tr><tr><td>1</td><td>07/03/2007</td><td>Issued for Information</td></tr><tr><td>2</td><td>25/05/2009</td><td>Staff Amenities updated and Manuscripts Furniture updated</td></tr><tr><td>3</td><td>18/09/2009</td><td>Compactus updated</td></tr><tr><td>4</td><td>07/01/2011</td><td>Brindabella Stacks updated</td></tr><tr><td>5</td><td>23/05/2012</td><td>Room L2.10 Compactus updated</td></tr><tr><td>6</td><td>30/07/2013</td><td>Shelving updated</td></tr><tr><td>7</td><td>10/06/2014</td><td>Strong Room shelving and Dimensions corrected</td></tr><tr><td>8</td><td>03/03/2016</td><td>External Walls and Windows corrected; Details added Services Cores and Stairs corrected - site measured</td></tr><tr><td>8a</td><td>13/04/2016</td><td>Design dimensions per PDFs 1963, 1981, etc added Columns corrected against structural drawings (1963)</td></tr><tr><td>8b</td><td>22/04/2016</td><td>Internal Walls corrected (where remaining); Construction shown</td></tr><tr><td></td><td>28/04/2016</td><td>2016 site measurements recorded; adjustments made.</td></tr></table>			NO.	DATE	REVISION	1	07/03/2007	Issued for Information	2	25/05/2009	Staff Amenities updated and Manuscripts Furniture updated	3	18/09/2009	Compactus updated	4	07/01/2011	Brindabella Stacks updated	5	23/05/2012	Room L2.10 Compactus updated	6	30/07/2013	Shelving updated	7	10/06/2014	Strong Room shelving and Dimensions corrected	8	03/03/2016	External Walls and Windows corrected; Details added Services Cores and Stairs corrected - site measured	8a	13/04/2016	Design dimensions per PDFs 1963, 1981, etc added Columns corrected against structural drawings (1963)	8b	22/04/2016	Internal Walls corrected (where remaining); Construction shown		28/04/2016	2016 site measurements recorded; adjustments made.	<div>to all elements. Doors corrected; Fire walls shown</div> <table><tr><td>8b</td><td>28/04/2016</td><td>Manuscripts Reading Room measured-draw recreated</td></tr><tr><td>8c</td><td>01/05/2016</td><td>Toilet areas updated; Computer Room updated</td></tr><tr><td></td><td>02/05/2016</td><td>Level 2 Refurbishment updated</td></tr><tr><td>8d</td><td>16/05/2016</td><td>Floor Finishes added/updated</td></tr><tr><td>8e</td><td>20/08/2016</td><td>AutoCAD layer &amp; colours rationalised and layers adjusted to conform with drafting standard</td></tr><tr><td>9</td><td>31/08/2016</td><td>RE-ISSUED for Information</td></tr><tr><td>9a</td><td>16/09/2016</td><td>Floor coverings legend added</td></tr><tr><td>9b</td><td>09/11/2016</td><td>Compactus in Hurley Stacks changed</td></tr><tr><td>v2</td><td>14/02/2018</td><td>No changes; copied to database manager</td></tr><tr><td></td><td>18/02/2018</td><td>Services legend deleted</td></tr><tr><td>v3</td><td>25/07/2018</td><td>No significant changes; copied to database manager</td></tr><tr><td>v4</td><td>31/07/2018</td><td>Created</td></tr></table>			8b	28/04/2016	Manuscripts Reading Room measured-draw recreated	8c	01/05/2016	Toilet areas updated; Computer Room updated		02/05/2016	Level 2 Refurbishment updated	8d	16/05/2016	Floor Finishes added/updated	8e	20/08/2016	AutoCAD layer & colours rationalised and layers adjusted to conform with drafting standard	9	31/08/2016	RE-ISSUED for Information	9a	16/09/2016	Floor coverings legend added	9b	09/11/2016	Compactus in Hurley Stacks changed	v2	14/02/2018	No changes; copied to database manager		18/02/2018	Services legend deleted	v3	25/07/2018	No significant changes; copied to database manager	v4	31/07/2018	Created	<div>DRAWN BY</div> <div>M Perryman</div> <div>AUTHORISED FOR ISSUE BY</div> <div>DATE / /</div> <div>STATUS</div> <div>Redraw - For Information</div>		<div>SCALE</div> <div><div>0200040006000800010000mm</div><div>1:300 @ A31:150 @ A1</div></div> <div>BASE PLAN REFERENCE NUMBER</div> <div>NLA-AP-L2-MBP</div> <div>Version</div> <div>ISSUE DATE</div> <div>18 May 2016</div>		<div></div> <div>CIENT</div> <div>National Library Of Australia</div> <div>PROJECT</div> <div>Master Base Plans - Architectural</div> <div>BLOCK</div> <div>4</div> <div>SECTION</div> <div>27</div> <div>DIVISION</div> <div>PARKES</div>		<div>DRAWING TITLE</div> <div>LEVEL 2 FLOOR PLAN + FURNITURE</div> <div>G:/DIV6/Building and Security/Services/Builman/Drawings/Master Base Plans/Drawings/NLAParkes/Architectural/NLA-AP-L2-MBP-rev9b-v4.dwg</div> <div>Sheet "Floor Plan + Furniture"</div> <div>TRIM:NLA14/242</div> <div>DRAWING NUMBER</div> <div>NLA-AP-L2-MBP</div> <div>Rev</div> <div>9</div>	
NO.	DATE	REVISION																																																																																			
1	07/03/2007	Issued for Information																																																																																			
2	25/05/2009	Staff Amenities updated and Manuscripts Furniture updated																																																																																			
3	18/09/2009	Compactus updated																																																																																			
4	07/01/2011	Brindabella Stacks updated																																																																																			
5	23/05/2012	Room L2.10 Compactus updated																																																																																			
6	30/07/2013	Shelving updated																																																																																			
7	10/06/2014	Strong Room shelving and Dimensions corrected																																																																																			
8	03/03/2016	External Walls and Windows corrected; Details added Services Cores and Stairs corrected - site measured																																																																																			
8a	13/04/2016	Design dimensions per PDFs 1963, 1981, etc added Columns corrected against structural drawings (1963)																																																																																			
8b	22/04/2016	Internal Walls corrected (where remaining); Construction shown																																																																																			
	28/04/2016	2016 site measurements recorded; adjustments made.																																																																																			
8b	28/04/2016	Manuscripts Reading Room measured-draw recreated																																																																																			
8c	01/05/2016	Toilet areas updated; Computer Room updated																																																																																			
	02/05/2016	Level 2 Refurbishment updated																																																																																			
8d	16/05/2016	Floor Finishes added/updated																																																																																			
8e	20/08/2016	AutoCAD layer & colours rationalised and layers adjusted to conform with drafting standard																																																																																			
9	31/08/2016	RE-ISSUED for Information																																																																																			
9a	16/09/2016	Floor coverings legend added																																																																																			
9b	09/11/2016	Compactus in Hurley Stacks changed																																																																																			
v2	14/02/2018	No changes; copied to database manager																																																																																			
	18/02/2018	Services legend deleted																																																																																			
v3	25/07/2018	No significant changes; copied to database manager																																																																																			
v4	31/07/2018	Created																																																																																			



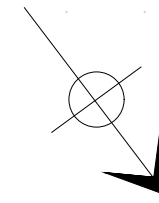



P:\VLA homework\Current drawing\updaung - work area\waster plans - kcdraw & Corrections\Architectural\NLA-AF-L3-MBP-rev8a-v3.dwg, 30/08/2018 10:01:04 PM, AutoCAD PLOT (General Documentation).pc3

F:\NLA homework Current Drawing Updating - Work Area Master Plans - Redraw & Corrections\Architectural\NLA-AP-L4-MBP-rev11a-v2.dwg, 30/08/2016 10:18:40 PM, AutoCAD PLOT (General Documentation).pc3

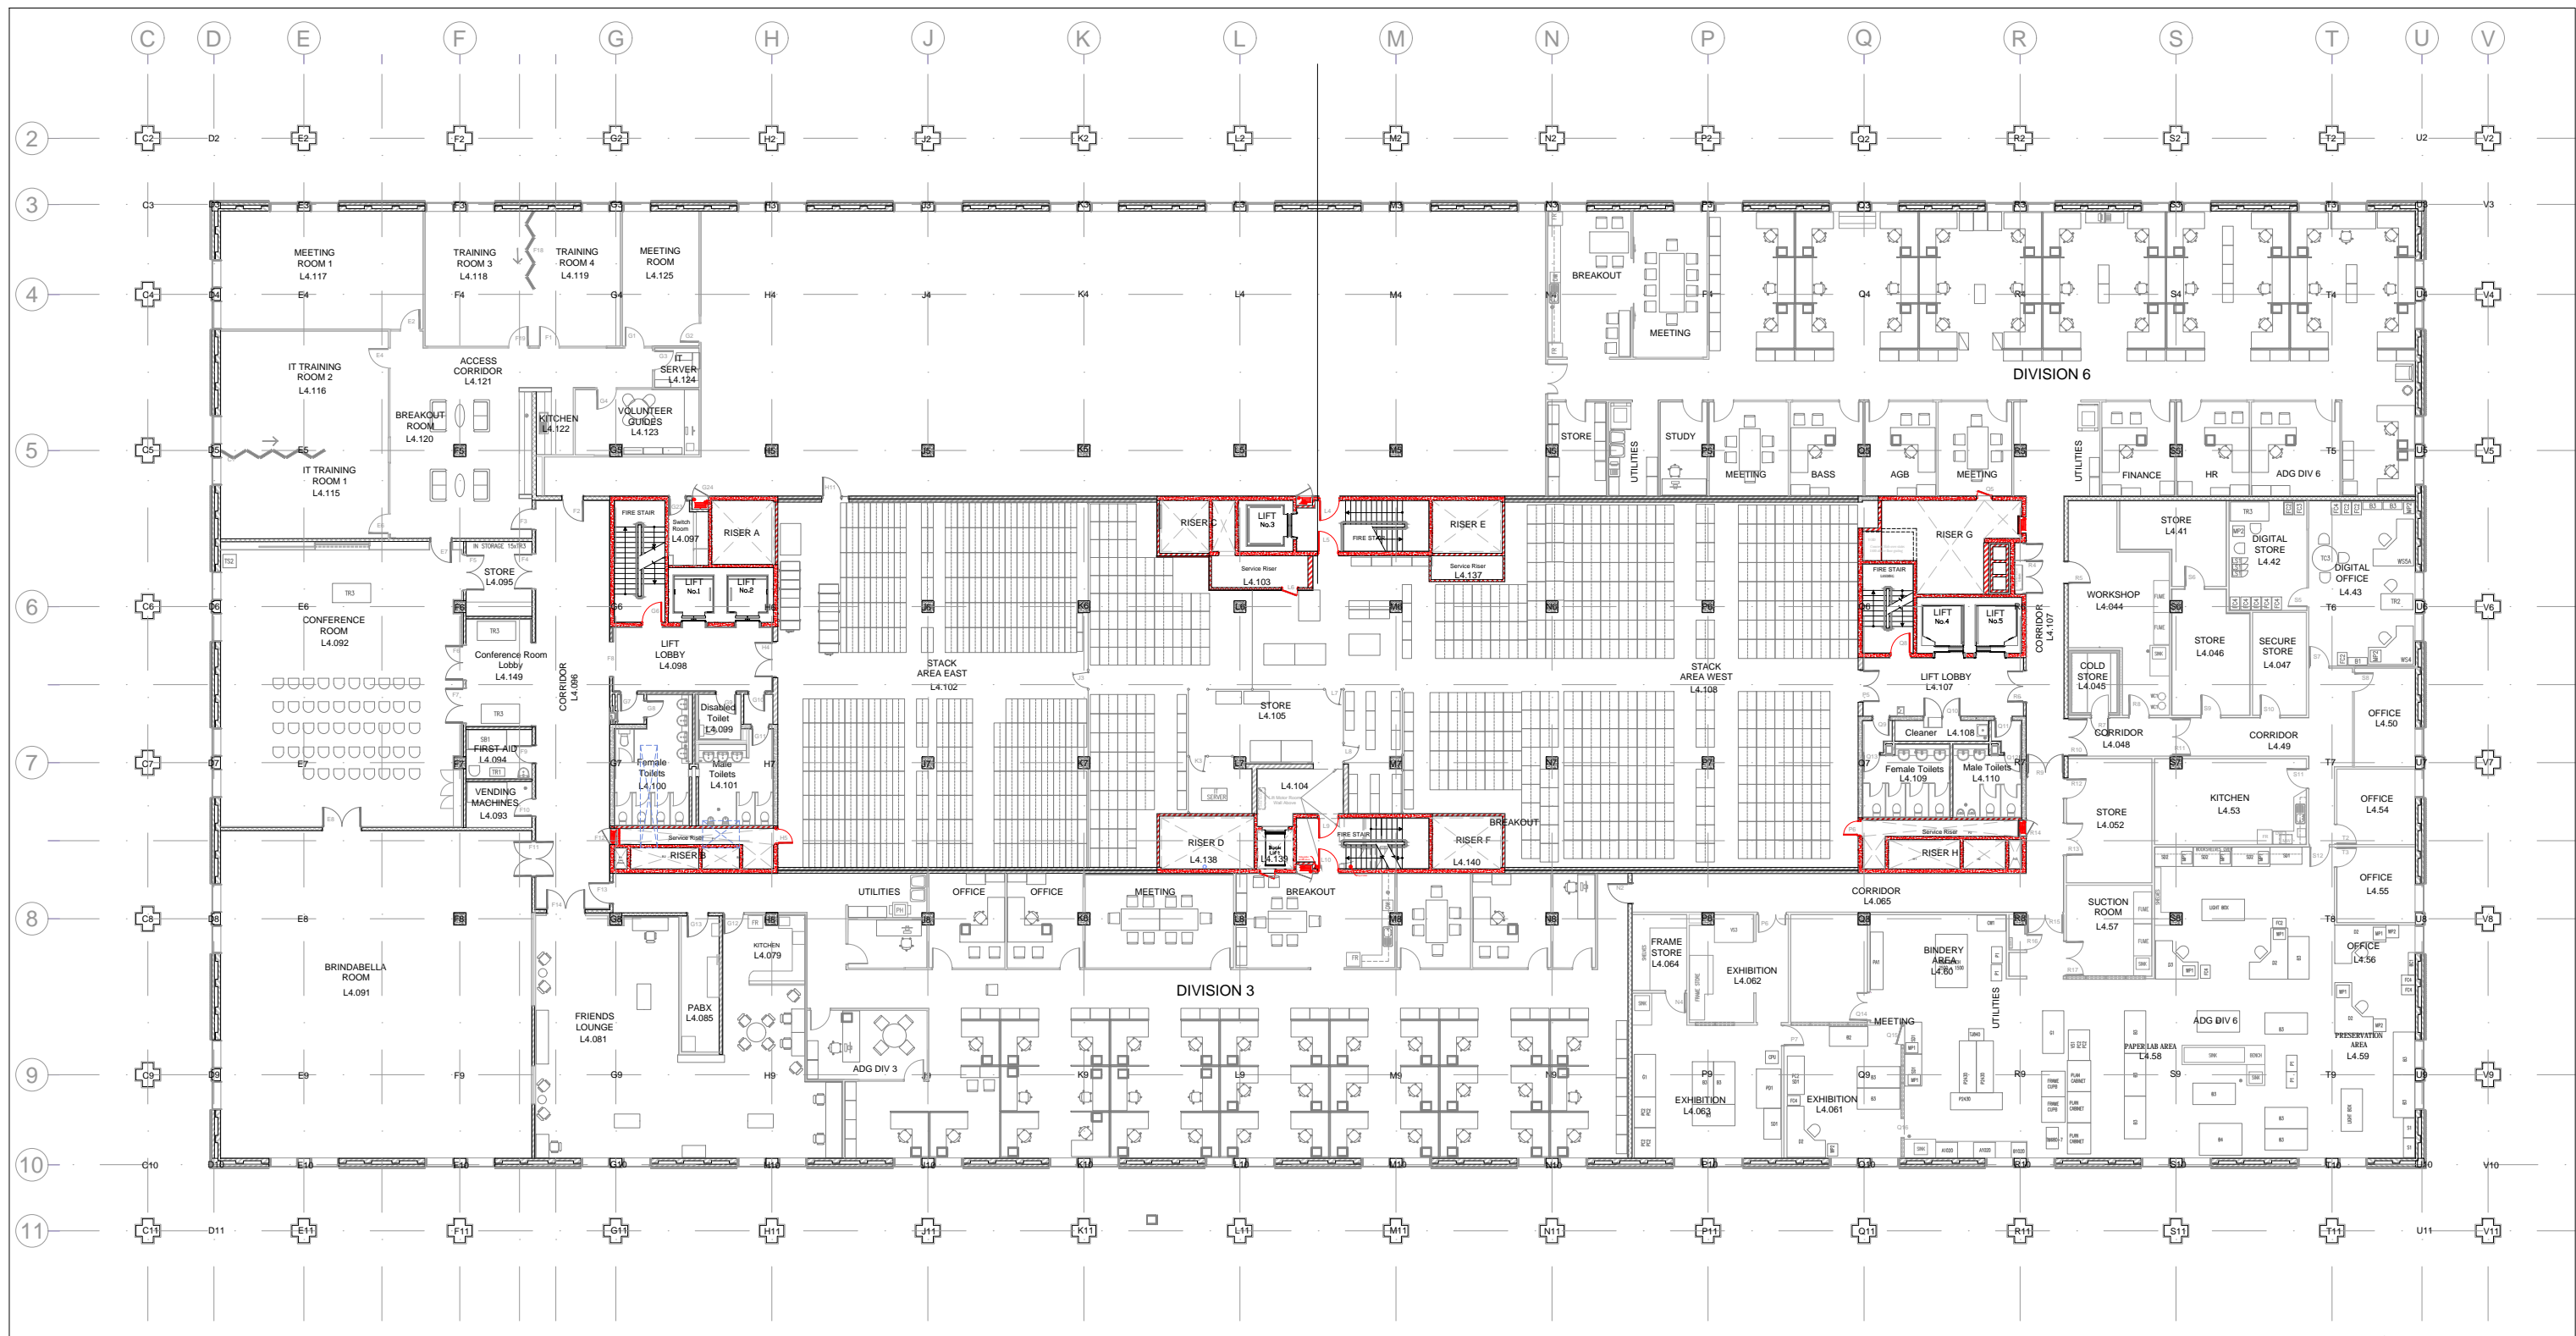


## LEVEL 4

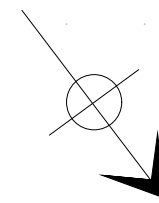


 
DRAWING REVISIONS			DRAWN BY  MTP	SCALE <div><div><div>0</div><div>2000</div><div>4000</div><div>6000</div><div>8000</div><div>10000mm</div></div></div> 1:300 @ A3    1:150 @ A1		CLIENT  National Library Of Australia	DRAWING TITLE  LEVEL 4 FLOOR PLAN W FURNITURE			
NO.	DATE	REVISION				PROJECT  Master Base Plans - Architectural	G:/DIV6/Building and SecurityServices/Builman/ Drawings/Master Base Plans/Drawings/NLAParkes/Architectural/ NLA-AP-L4-MBP-rev11a~v2.dwg Sheet "Floor Plan w Furniture" <div>TRIM:NLA14/242</div>			
1	07/03/2007	Issued for Information	AUTHORISED FOR ISSUE BY  DATE  /   /	BASE PLAN REFERENCE NUMBER  NLA-AP-L4-MBP	Version  a	BLOCK 4	SECTION 27	DIVISION PARKES	DRAWING NUMBER  NLA-AP-L4-MBP	Rev 11
2	24/01/2008	Training Suites revised								
3	28/05/2009	Preservation Services updated	STATUS  INFORMATION	ISSUE DATE  22/2/16						
4	18/09/2009	Compactus updated								
5	08/04/2010	Book Lift Motor Room added (including stormwater pipe)	9j 29/08/2016 Door and Fire Door Asset Schedules removed; Blocks deleted AutoCAD layers & colours rationalised and layers adjusted to conform with drafting standard; Revision blocks revised	10 29/08/2016 RE-ISSUED for Information						
6	17/08/2010	FRIENDS LOUNGE updated								
7	22/02/2012	Volunteer Guides Room updated	10a 16/09/2016 Floor coverings added	11a 12/02/2018 Fitout updated for Division 3 and Division 6						
8	15/08/2012	BaSS Workstation area updated								
9	22/02/2016	External walls corrected; Detail added Service Cores and Stairs corrected (and site measured) Walls and Dimensions adjusted per PDFs 1963, 1981, etc Site measurements confirming corrections	9i 23/03/2016 Door numbers aligned; Other minor changes							




F:\VLA homework Current Drawing Updating - Work Area Master Plans - Redraw & Corrections\Architectural\NLA-AP-L5-MBP-rev4a-v3.dwg, 30/08/2018 10:20:33 P.M., AUTOCAD PLOT (General Documentation).pc3

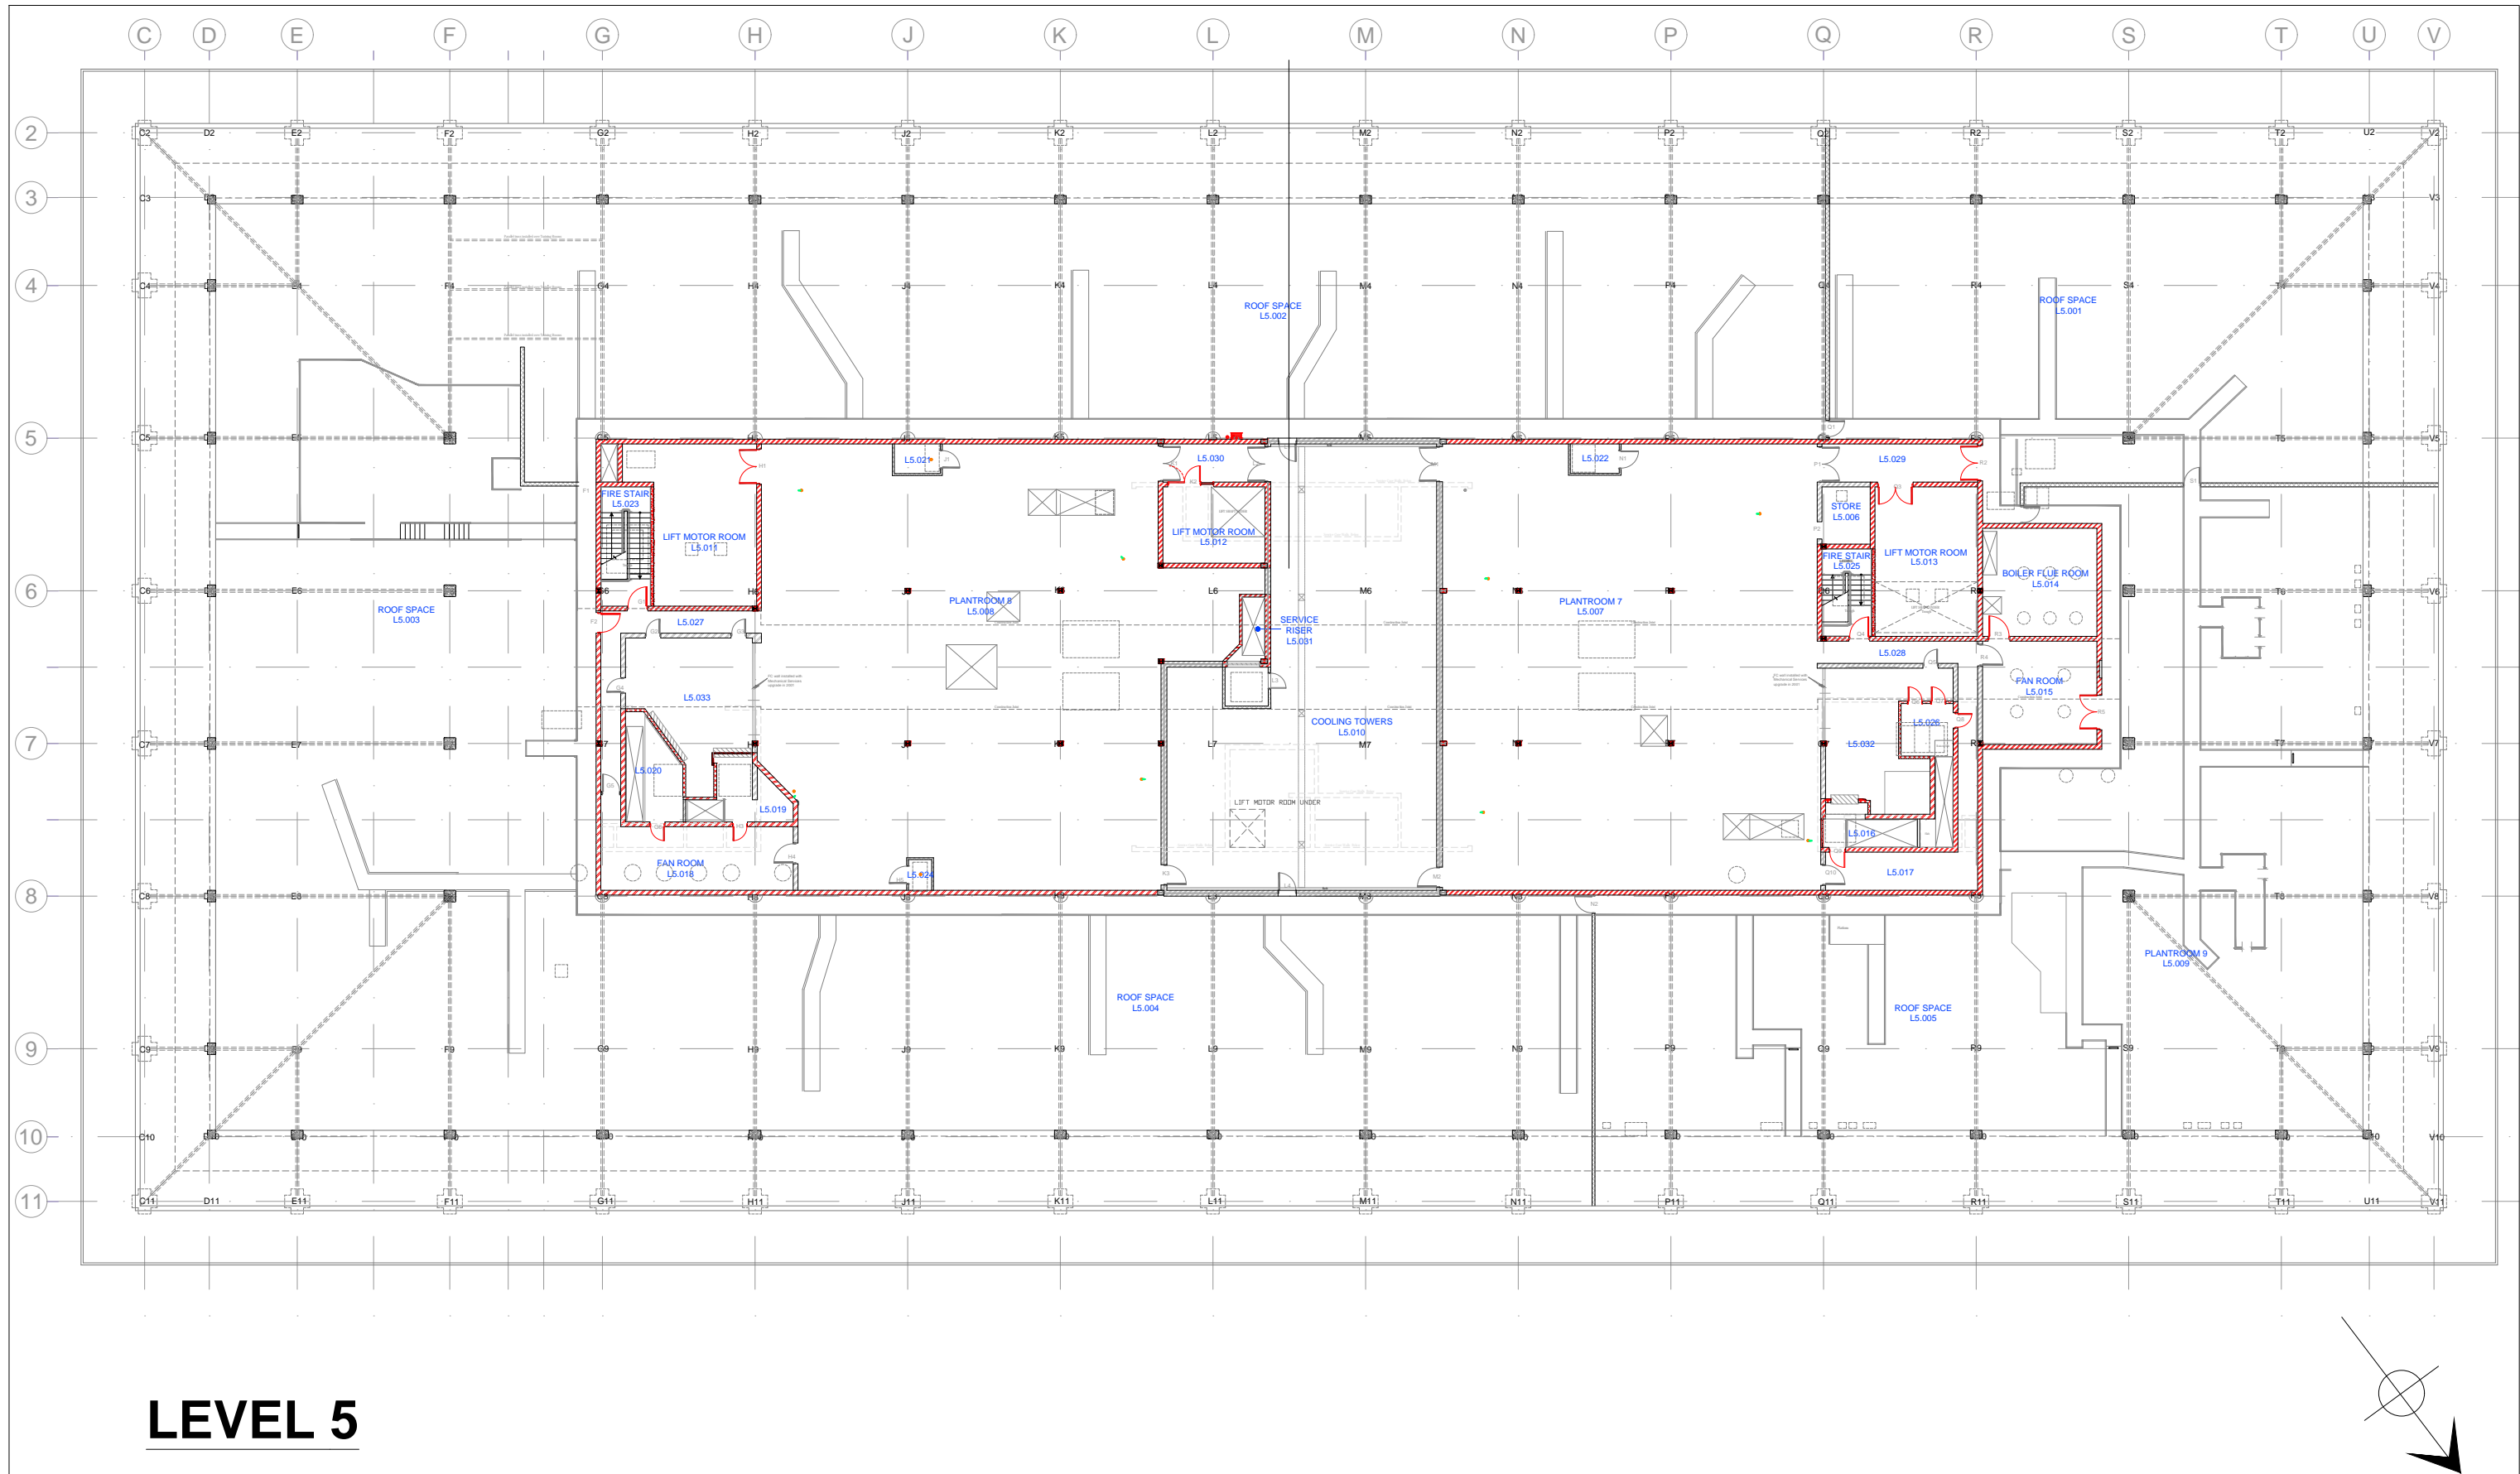

# LEVEL 5

DRAWING REVISIONS			DRAWN BY		SCALE			CLIENT			DRAWING TITLE										
NO.	DATE	REVISION	MTP		 1:300 @ A3    1:150 @ A1			National Library Of Australia			LEVEL 5 FLOOR PLAN										
1	07/03/2007	Issued for Information	AUTHORISED FOR ISSUE BY		DATE / /			BASE PLAN REFERENCE NUMBER NLA-AP-L5-MBP		Version T		PROJECT Master Base Plans - Architectural		G:/DIV6/Building and Security/Services/Builman/ Drawings/Master Base Plans/Drawings/NLAParkes/Architectural/ NLA-AP-L5-MBP-rev4a-v3.dwg Sheet "Floor Plan"							
2	24/11/2009	Grid numbers added	STATUS INFORMATION		ISSUE DATE 07.03.07				BLOCK 4			SECTION 27			DIVISION PARKES			DRAWING NUMBER NLA-AP-L5-MBP		Rev 4	
3	12/12/2015	Complete redraw. Roof structure shown. Dimensions recorded All walls & doors checked and corrected. Fire walls & doors shown Walkways added. Roof space balustrade corrected																			
4	29/08/2016	AutoCAD layer & colours rationalised and layers adjusted to conform with drafting standard. RE-ISSUED for Information																			
a	08/09/2017	Door numbers updated																			
v1	14/02/2018	Minor dimensional changes; copied to database manager																			
v2	25/07/2018	No significant changes; copied to database manager																			
v3	31/07/2018	Created																			

F:\VLA homework Current Drawing Updating - Work Area Master Plans - Redraw & Corrections\Architectural\NLA-AP-LG1-MBP-rev10b-v3.dwg, 29/08/2018 9:19:28 PM, AutoCAD PLOT (General Documentation).pc3

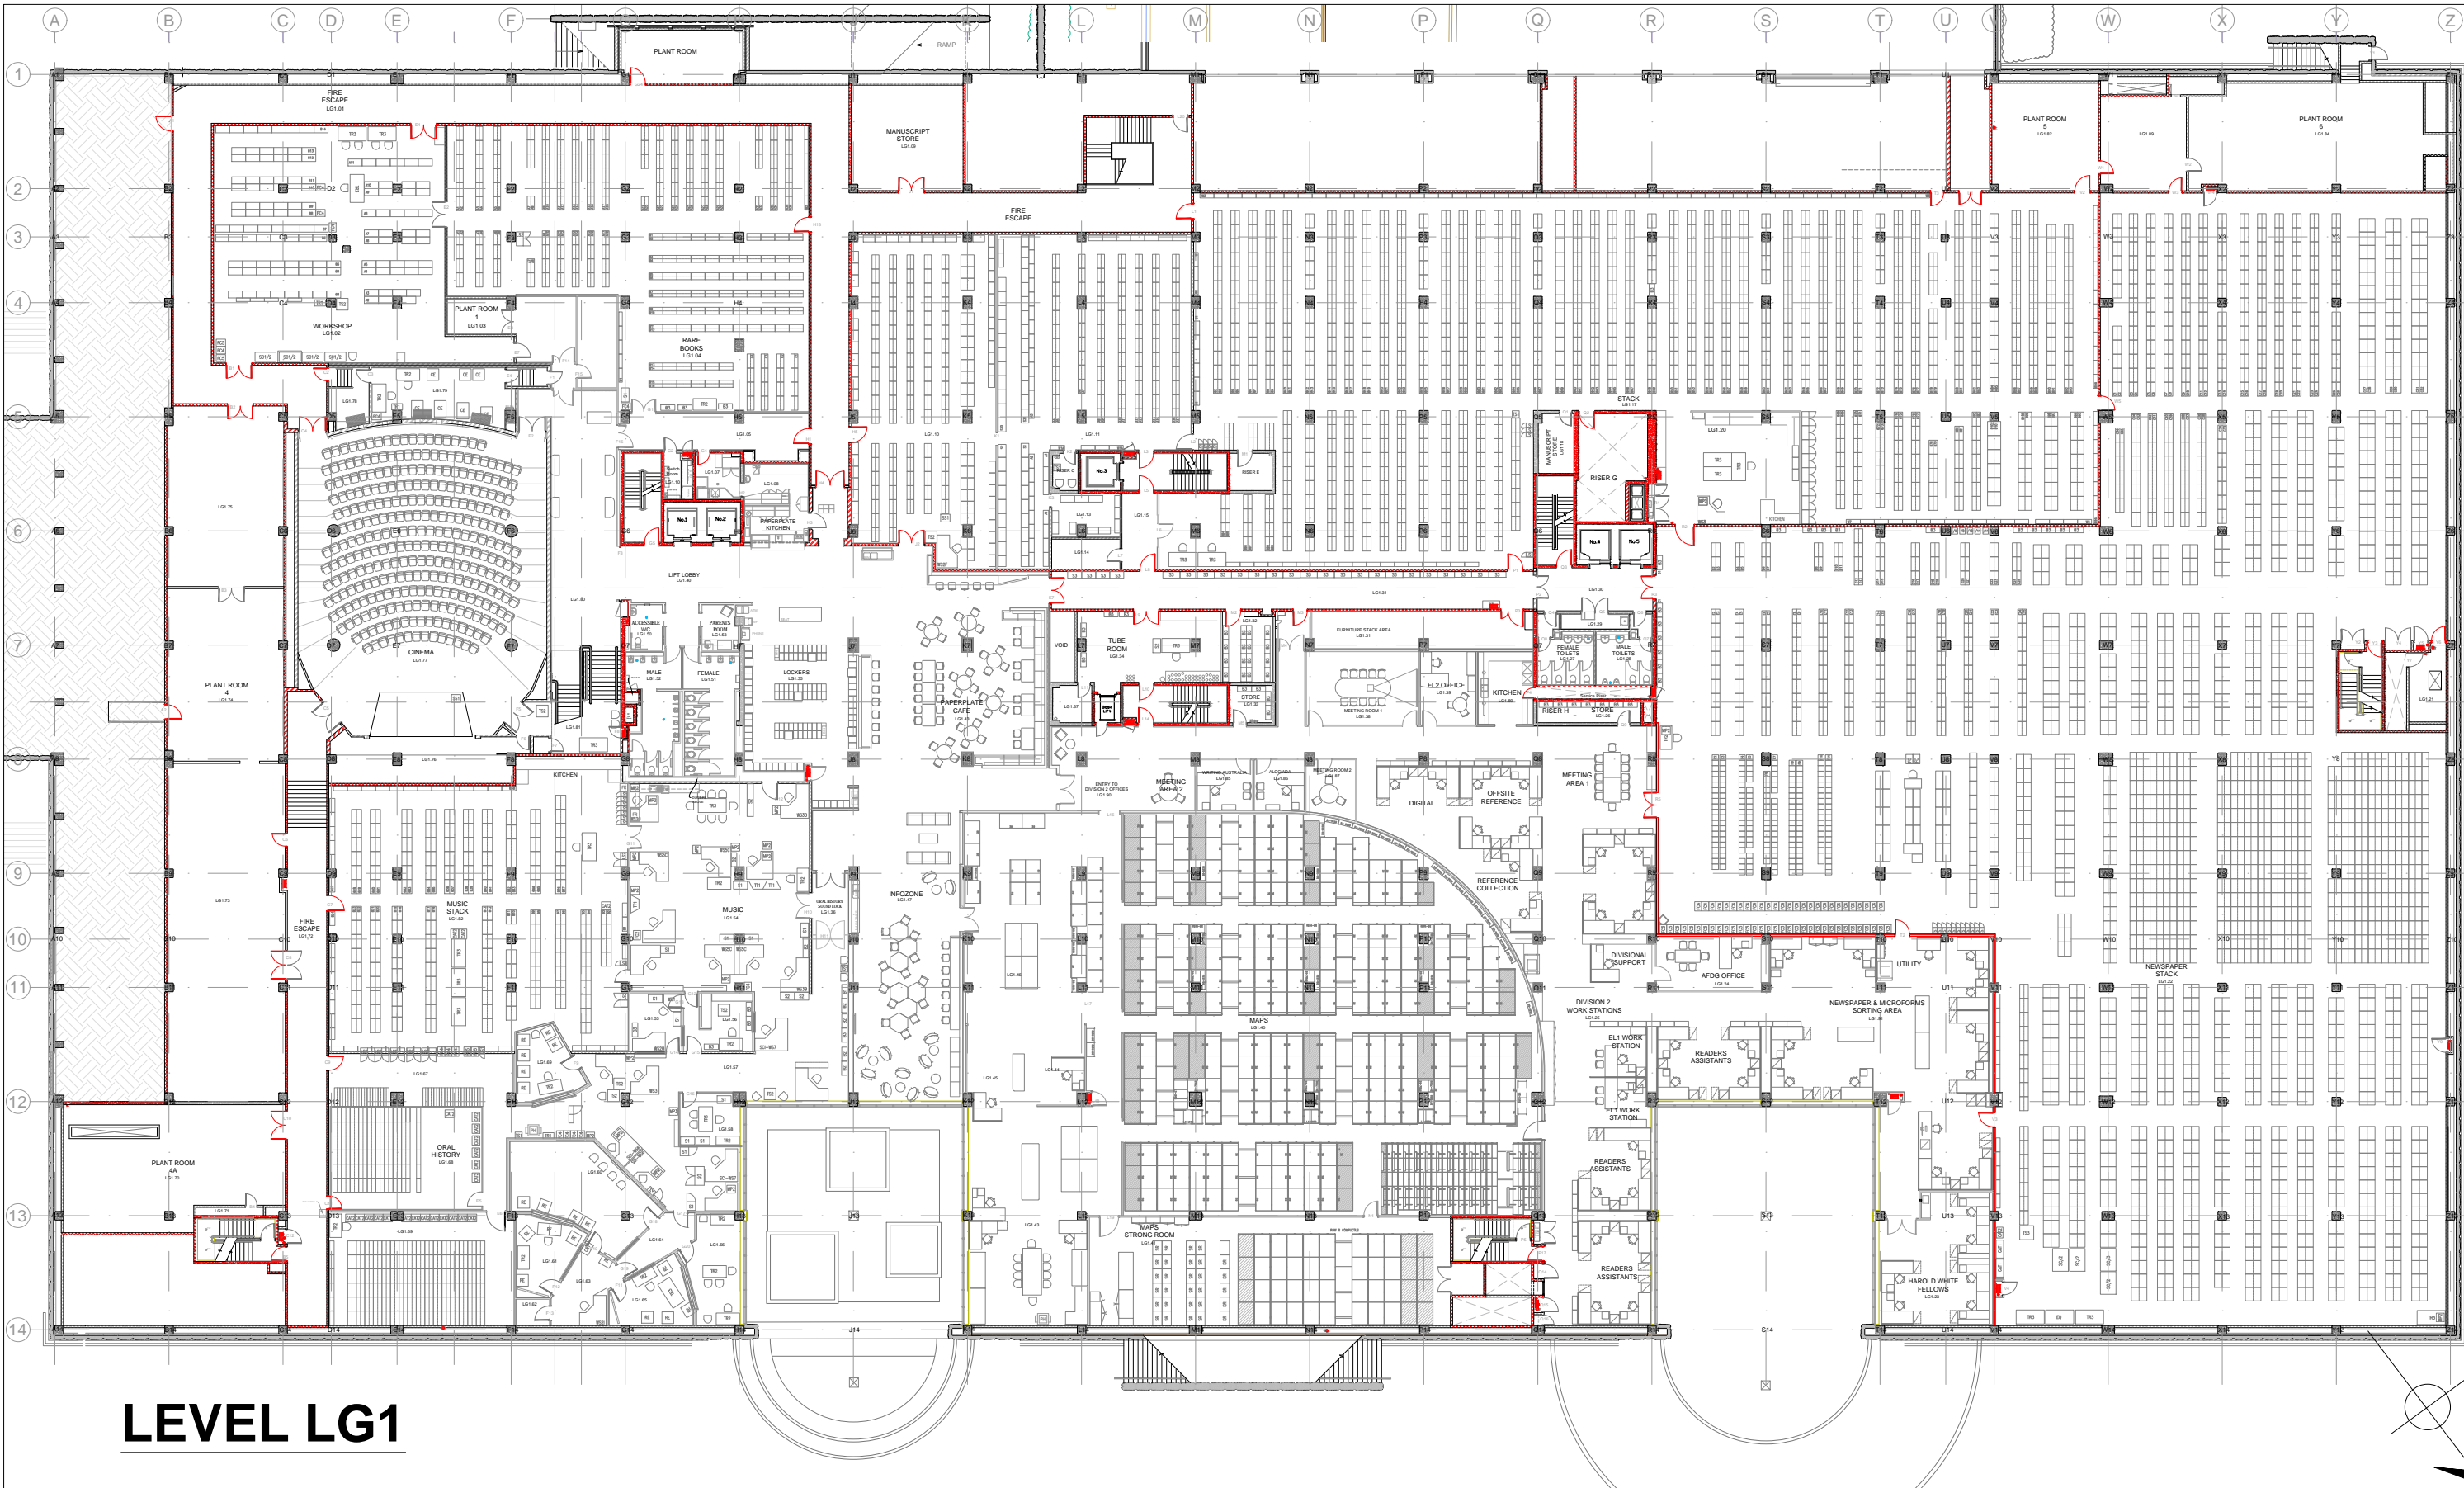

DRAWING REVISIONS		
NO.	DATE	REVISION
1	07/03/2007	Issued for information
2	18/09/2009	Compactus updated
3	05/02/2010	Plant Room 6 walls corrected
4	16/03/2010	Fire Corridor walls corrected; South external wall corrected
5	18/11/2010	South Disabled Access ramp and steps added
6	10/04/2013	Theatre seating and stairs added
7	30/07/2013	Shelving upgraded
8	22/07/2014	Plant Room Fire Doors upgraded
9	27/10/2015	External walls detailed and corrected; External stairs corrected Service cores, lifts and internal stairs corrected Internal walls detailed and corrected from site measurements
9e	27/10/2015	Public areas and Amenities updated; Paper Plate cafe updated Division 2 Offices; Oral History; Theatre & Foyer details updated

9f	20/05/2016	AutoCAD layers, colours and line weights standardised Floor Coverings added; Amenities area updated
	23/07/2016	Maps Refurbishment updated; North Core Toilets updated
10	29/08/2016	Revision table relocated; RE-ISSUED for information
10a	16/09/2016	Floor coverings Legend added
10b v1	14/02/2018	No changes; copied to database manager
v2	25/07/2018	Room Names reformatting; copied to database manager
v3	31/07/2018	Created

DRAWN BY	
M Perryman	
AUTHORISED FOR ISSUE BY	DATE
STATUS	
INFORMATION	

SCALE	
1:400 @ A3 1:200 @ A1	
BASE PLAN REFERENCE NUMBER	Version
NLA-AP-LG1-MBP	
ISSUE DATE	
30 August 2016	





CLIENT		
National Library Of Australia		
PROJECT		
Master Base Plans - Architectural		
BLOCK	SECTION	DIVISION
4	27	PARKES

DRAWING TITLE	
LEVEL LG1 FLOOR PLAN W FURNITURE	
PROJECT	
G:\DIV6\Building and Security\Bulman\Drawings\Master Base Plans\Drawings\NLA\Parkes\Architectural\NLA-AP-LG1-MBP-rev10b-v3.dwg Sheet "Floor Plan w Furniture"	
DRAWING NUMBER	
NLA-AP-LG1-MBP	
Rev	
10	





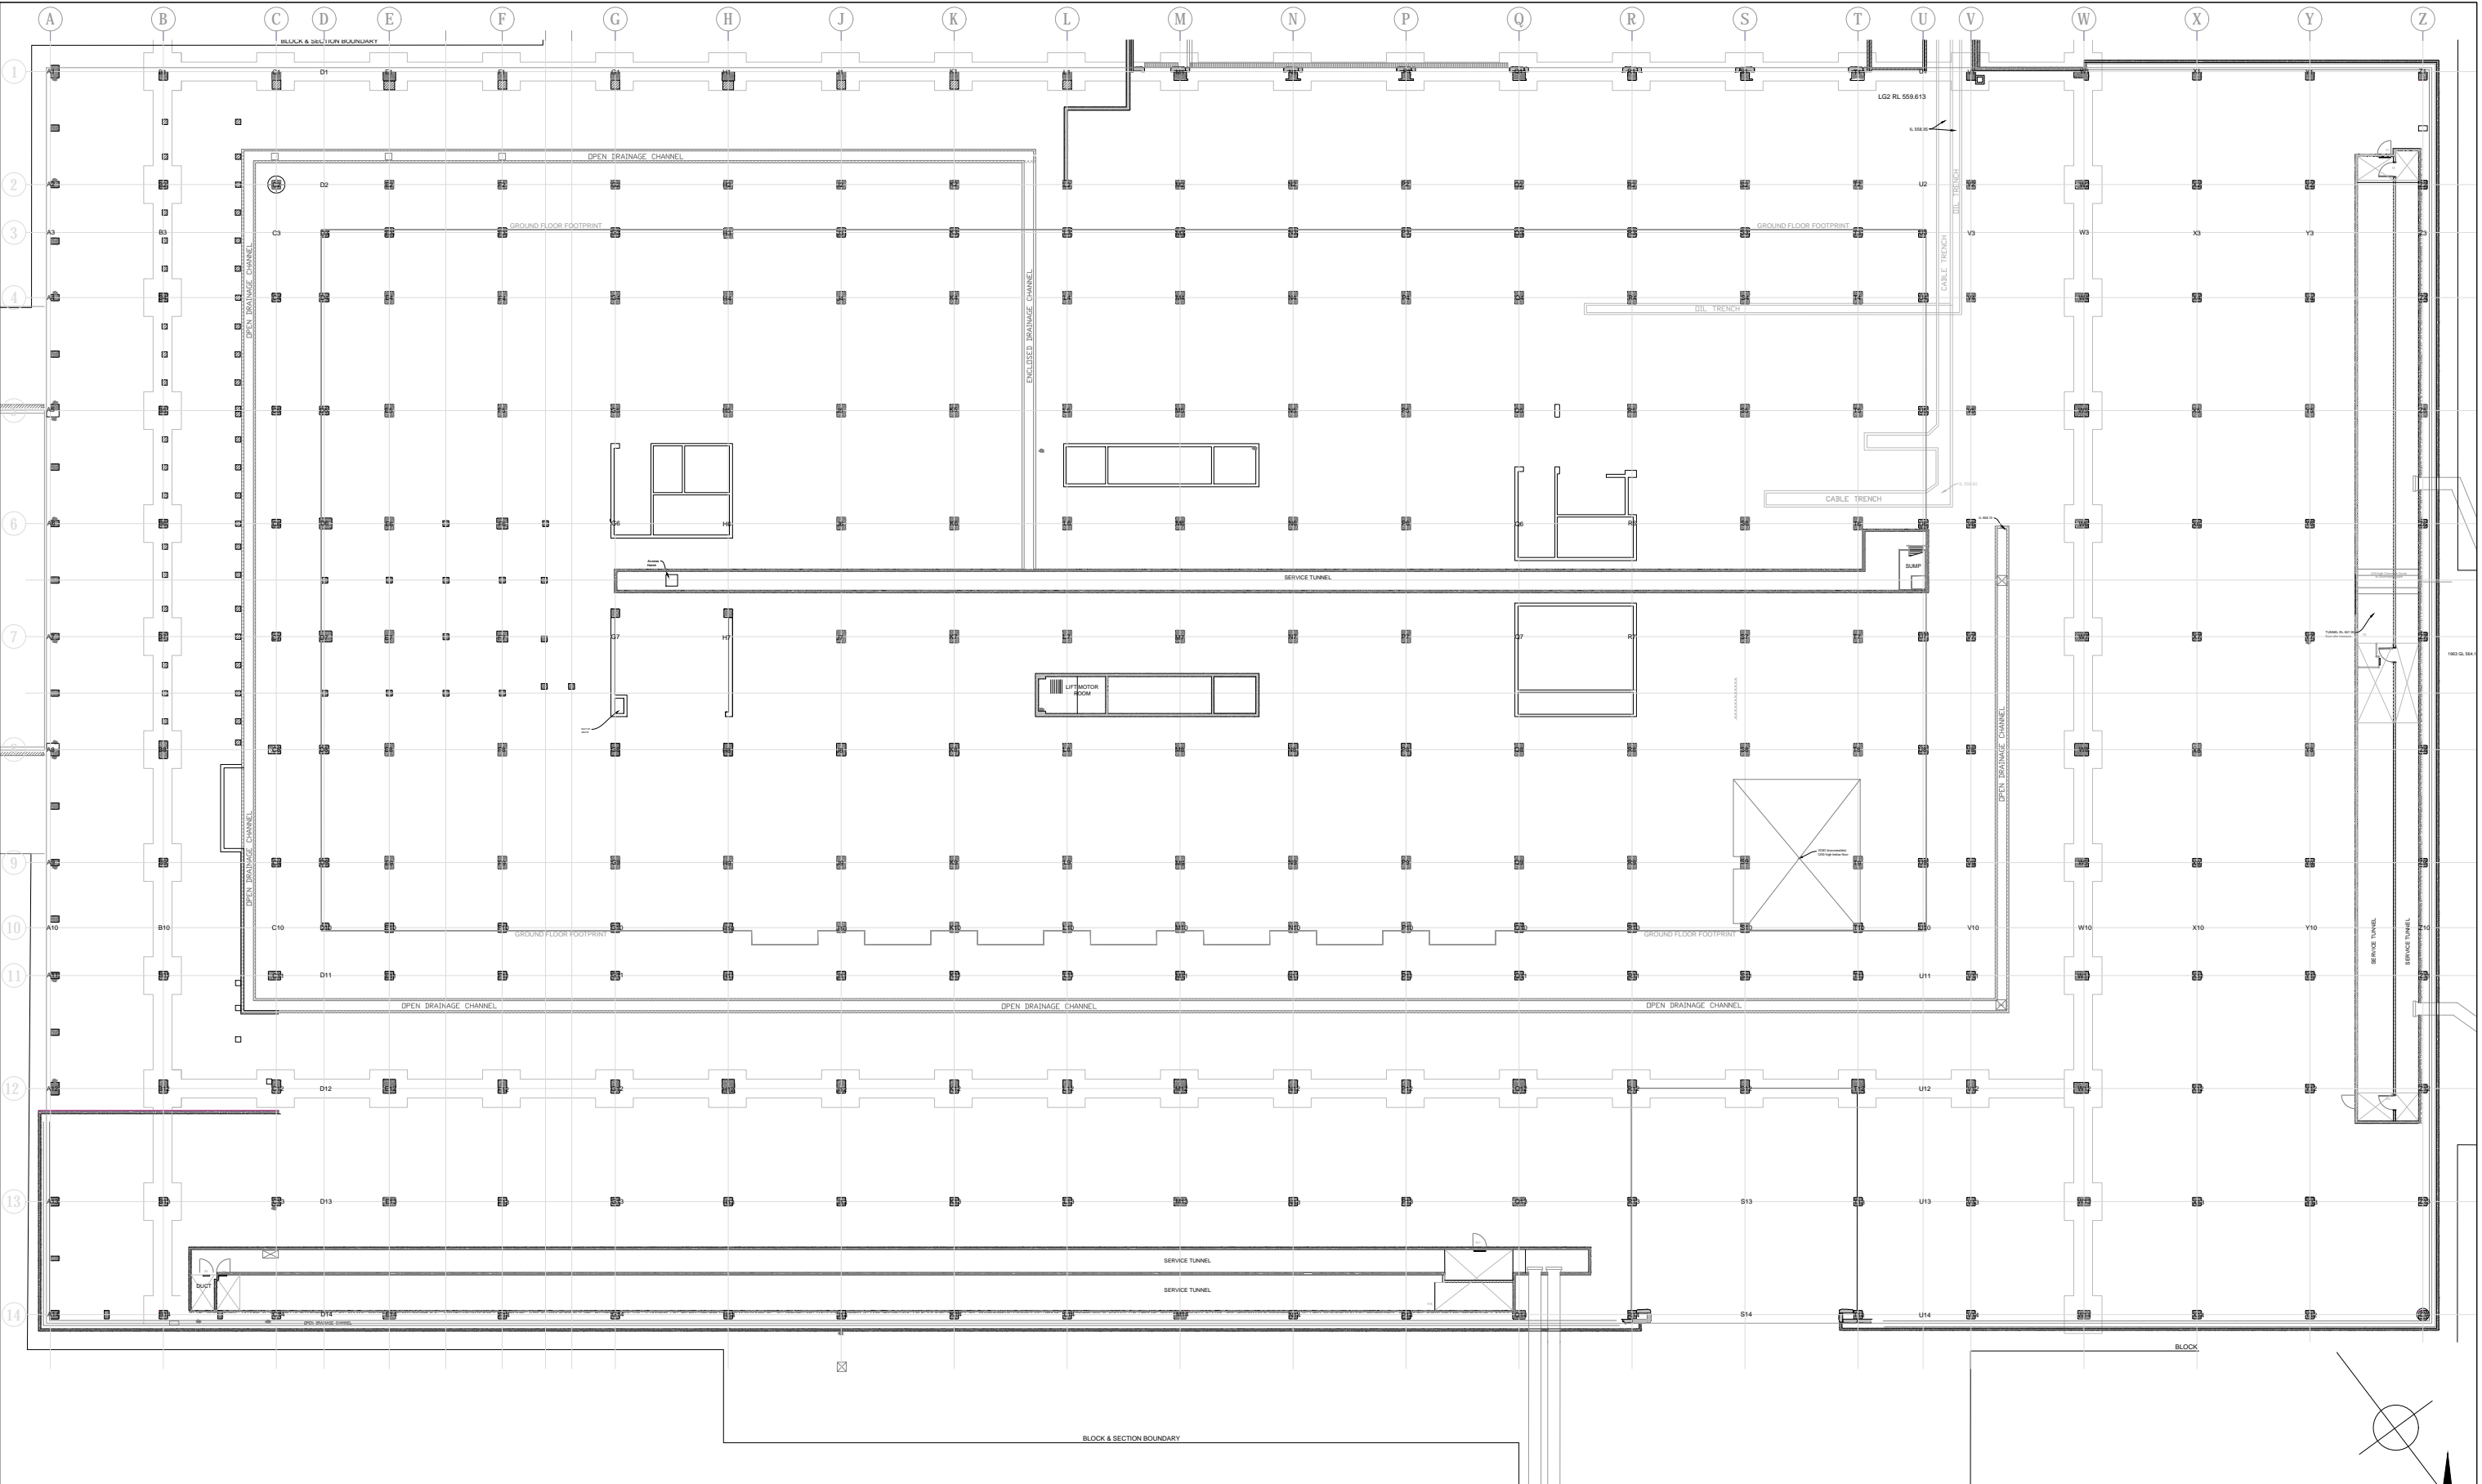

DRAWING REVISIONS			v2 31/07/2018 Created	DRAWN BY  MTP	SCALE <div><div><div></div><div>0</div><div>2000</div><div>4000</div><div>6000</div><div>8000</div><div>10000mm</div></div><div>1:400 @ A3</div><div>1:200 @ A1</div></div>		CLIENT <b>National Library Of Australia</b>	DRAWING TITLE <b>LEVEL LG3 (Service Tunnels) FLOOR PLAN</b>		
1 2 3 4	18/02/2008 02/04/2008 16/05/2011 28/08/2016	Issued for Information (PLF) Floor Plan Layout Updated (PLF) Door Numbers Added AutoCAD layer & colours rationalised and layers adjusted to conform with drafting standard. Base redrawn; RE-ISSUED for Information					PROJECT <b>Master Base Plans - Architectural</b>	G:/DIV6/Building and Security/Services/Builman/Drawings/Master Base Plans/Drawings/NLAParkes/Architectural/NLA-AP-LG3-MBP-rev5g-v2.dwg Sheet "FLOOR PLAN"		
5 a b c d, e f g	23/12/2016  18/01/2017 23/02/2017 18/06/2017 17/12/2017 15/02/2018	Book Lift Motor Room added (including stormwater pipe) Sub-floor drainage revised from old PDFs Internal Stormwater added; External services updated Site Plan Added (in full on Model space) More scaled layouts added, sections added ; services updated Services separated from services (new drawing NLA-HS-LG3-Rev1) Revise Layouts, print colours, tidy up layer					BLOCK <b>4</b>	SECTION <b>27</b>	DIVISION <b>PARKES</b>	DRAWING NUMBER <b>NLA-AP-LG3-MBP</b>
vi	25/07/2018	No significant changes; copied to database manager					Rev <b>5</b>			